Simpson / Simpson
Owls Nest #35
Map / Block / Lot

The District Health Department

CASWELL - CHATHAM - LEE - PERSON COUNTIES

2017 Owls Nest Rd

Water Supply and Sewage Disposal

IMPROVEMENTS PERMIT No. 5301

Date 4-26-85

Owner: Simpson & Simpson

Location: Owls Nest

Contractor: _____

Water Supply: Private _____ Public Comm.

— Dweet creek in back, hill up in front of house so a pump is necessary

Sewage Disposal Facilities: No. bedrooms 4 **Dishwasher**, Disposal, washing machine, other automatic appliances _____

Size of tank: 1000 gal Nitrification line: 300 ft. 3 ft. ditch

Other disposal facility: Sent tray - 120 ft. 3 ft. ditch (Reserve only)

Water supply and sewage disposal facilities location, installation and protection must meet state and local regulations.

Septic tank should be pumped out every 3 to 5 years and shall be maintained by owner in such a manner as not to create a public health hazard. Septic tank and nitrification line MUST BE INSPECTED AND APPROVED BY A MEMBER OF THE DISTRICT HEALTH DEPARTMENT STAFF BEFORE ANY PORTION OF THE INSTALLATION IS COVERED AND PUT INTO USE.

Date approved: _____

Well: _____

Sewage Disposal: _____

By: _____

Signed James R. Middleton
Sanitarian
Jimmy Collins

Counter-signed _____
(Owner or his representative)

Certificate of Completion

Date Approved: May 85 By: James R. Middleton
Sanitarian

(OVER)

Location of well and sewage disposal facilities sketched on back.

NOTE: Make sketch of installation showing lot size and shape, location of house, septic tanks, privies, water supplies, etc. Note special problems existing lot. Write in measurements in order that installations may be located at later date. Note location of water supplies on adjacent lots.

(1)

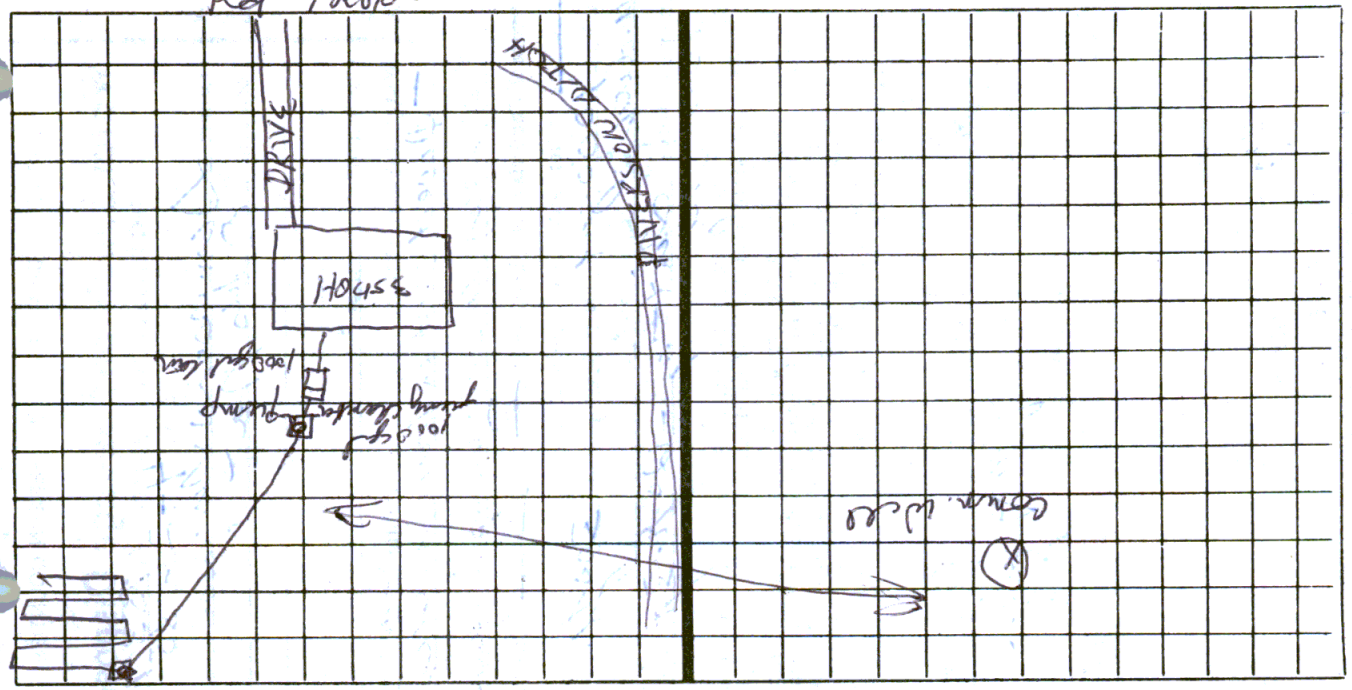

(2)